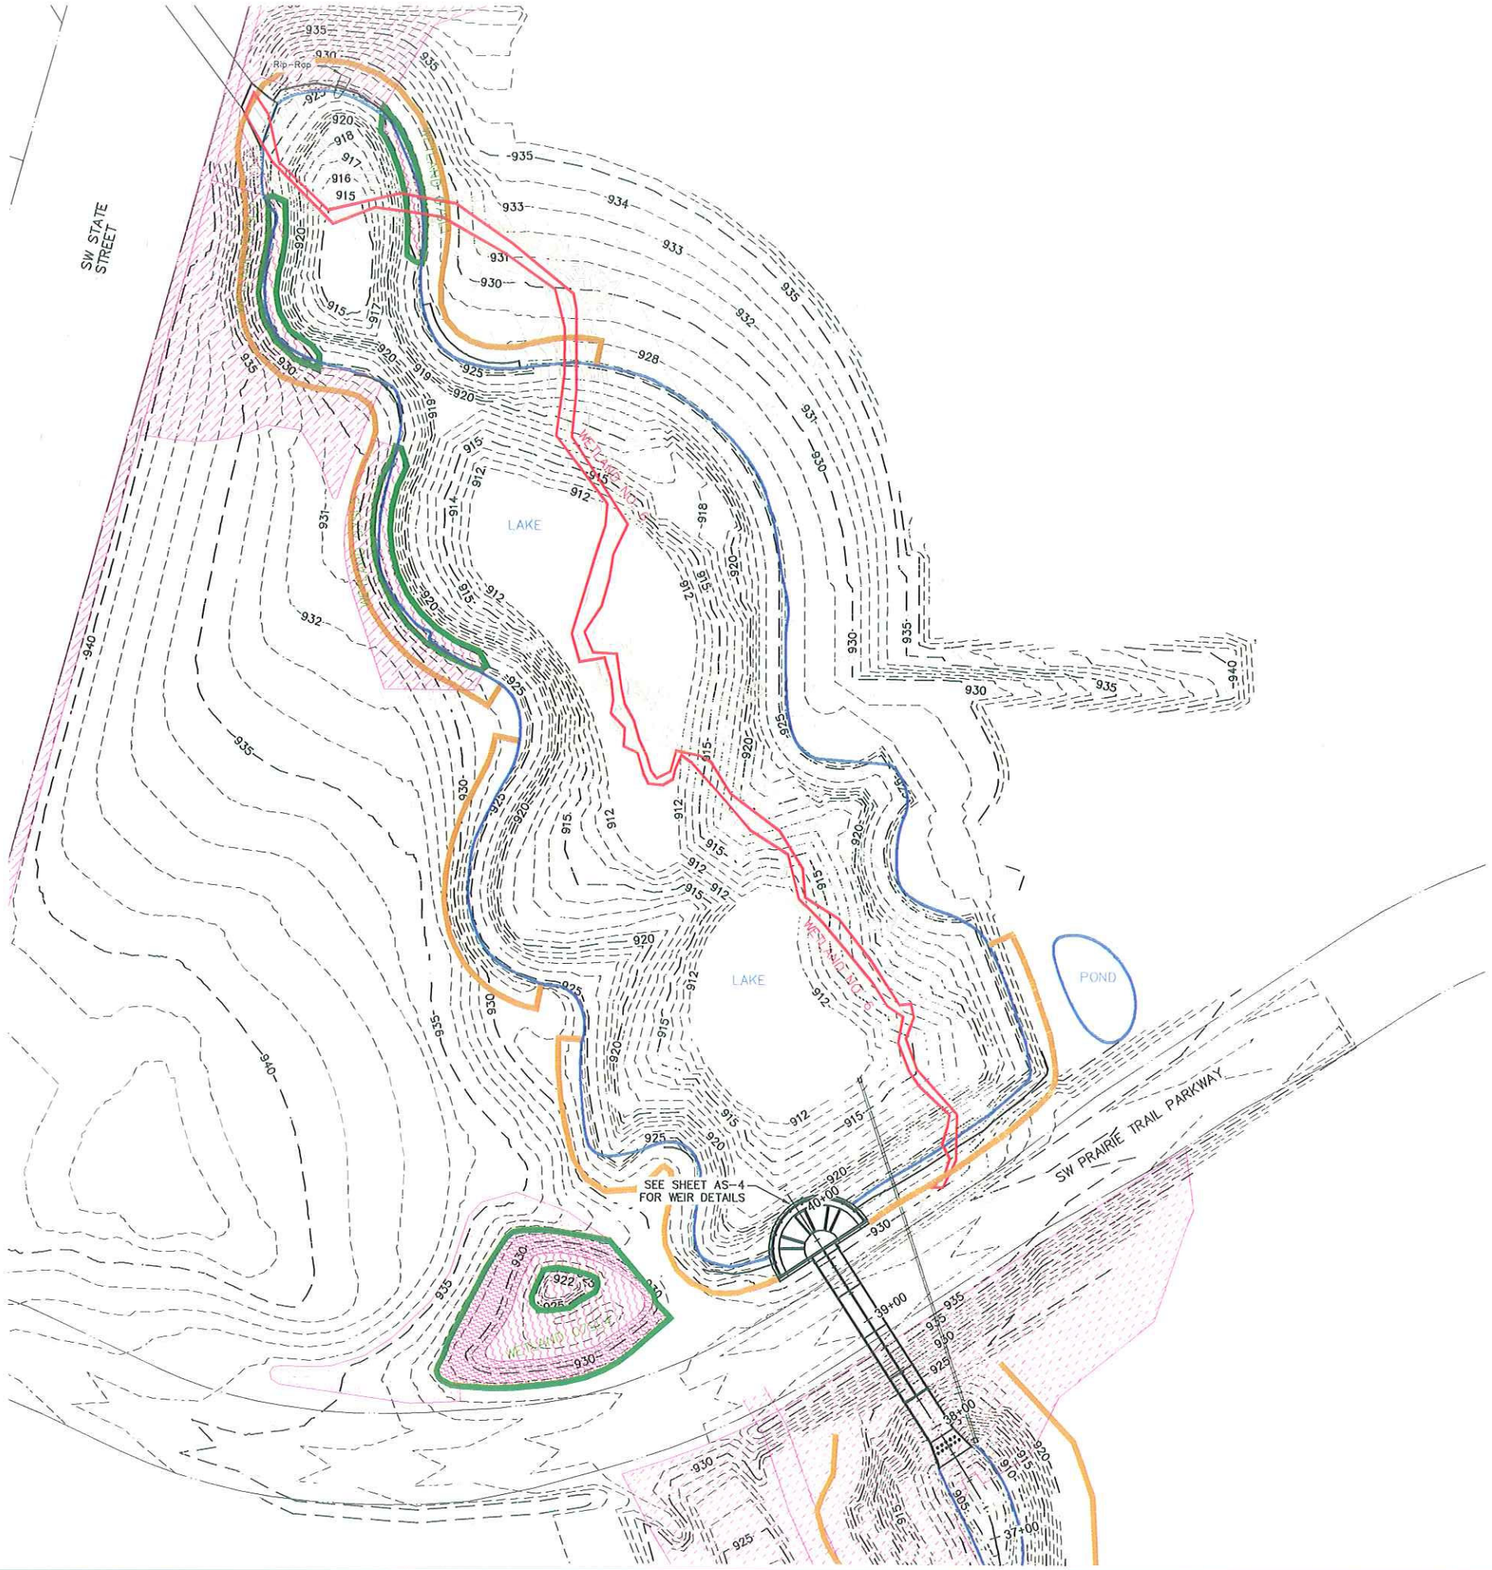

LEGEND

— — — —900'— — — —	Proposed Contour
900'	Existing Contour
	Flowline of Saylor Creek
	Rip-Rap
	20' Shoreline Buffer
	Edge of Water
	Constructed Wetland Boundary
	Existing Wetland Boundary
	Mitigated Wetland Boundary
	EW1 Stream Bank/Wetland Grass Mix
	DS1 Grass Seed Mix for Dryer Slopes
	Native Prairie Savanna Seed Mix
	Native Prairie Mesic Seed Mix
	Native Wet Prairie Swale/Edge Seed Mix
	Native Wetland/Flooded Seed Mix

NORTH

60 0 30

SCALE: 1" = 60'

2525 N ANKENY BLVD, SUITE 121
ANKENY, IOWA - 50023-4703
(515) 965-0723 voice - (515) 965-5322 fax
Civil Engineering - Land Surveying
Landscape Architecture
NILLES ASSOCIATES

REVISIONS:

NOTICE: NILLES ASSOCIATES, INC. WARRANTS ANY PLANS, SPECIFICATIONS, OR REPORTS TO BE FREE OF PROBLEMS WHICH ARISE FROM FAILURE TO FOLLOW THE ENGINEER'S INTENT WHEN THE ENGINEER'S INTENT THEY CONVEY, ON THE BASIS OF THE ENGINEER'S EXPERIENCE AND ESTABLISHED PRACTICE, HAVE BEEN REASONABLY TO OBTAIN AND/OR FOLLOW THE ENGINEER'S GUIDANCE. WITHIN RECENT 12 MONTHS, NILLES ASSOCIATES, INC. HAS NOT BEEN NOTIFIED OF CONFLICTS WHICH ARE ALLEGED.

PROJECT: Saylor Creek Channel Improvements
Ankeny, Iowa

TITLE: South Lake Area

NA No.:	08113
DATE:	08-26-2010
DRAWN BY:	ADS/TJH
CHECKED BY:	RJS
SCALE:	AS NOTED
DWG No.:	AS-3
SHEET No.:	3/6

J:\Land Projects\2008113\Wetland As-Built\08113AS (Saylor Creek South).dwg